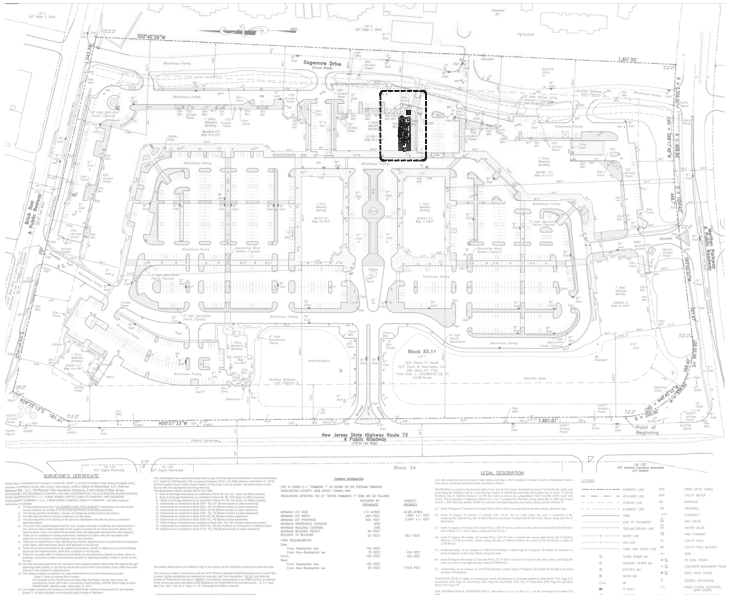

1 LOCATION SITE PLAN
N.T.S.

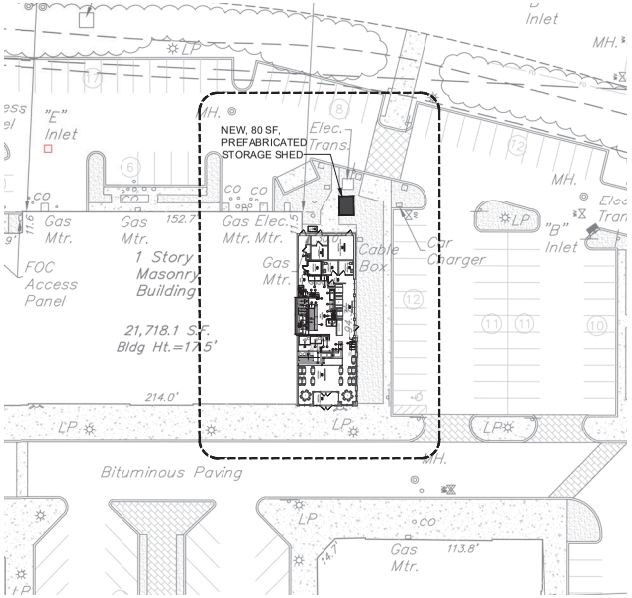

2 ENLARGED LOCATION SITE PLAN
1/32" = 1'-0"

4 PREFABRICATED SHED RENDERING
N.T.S.

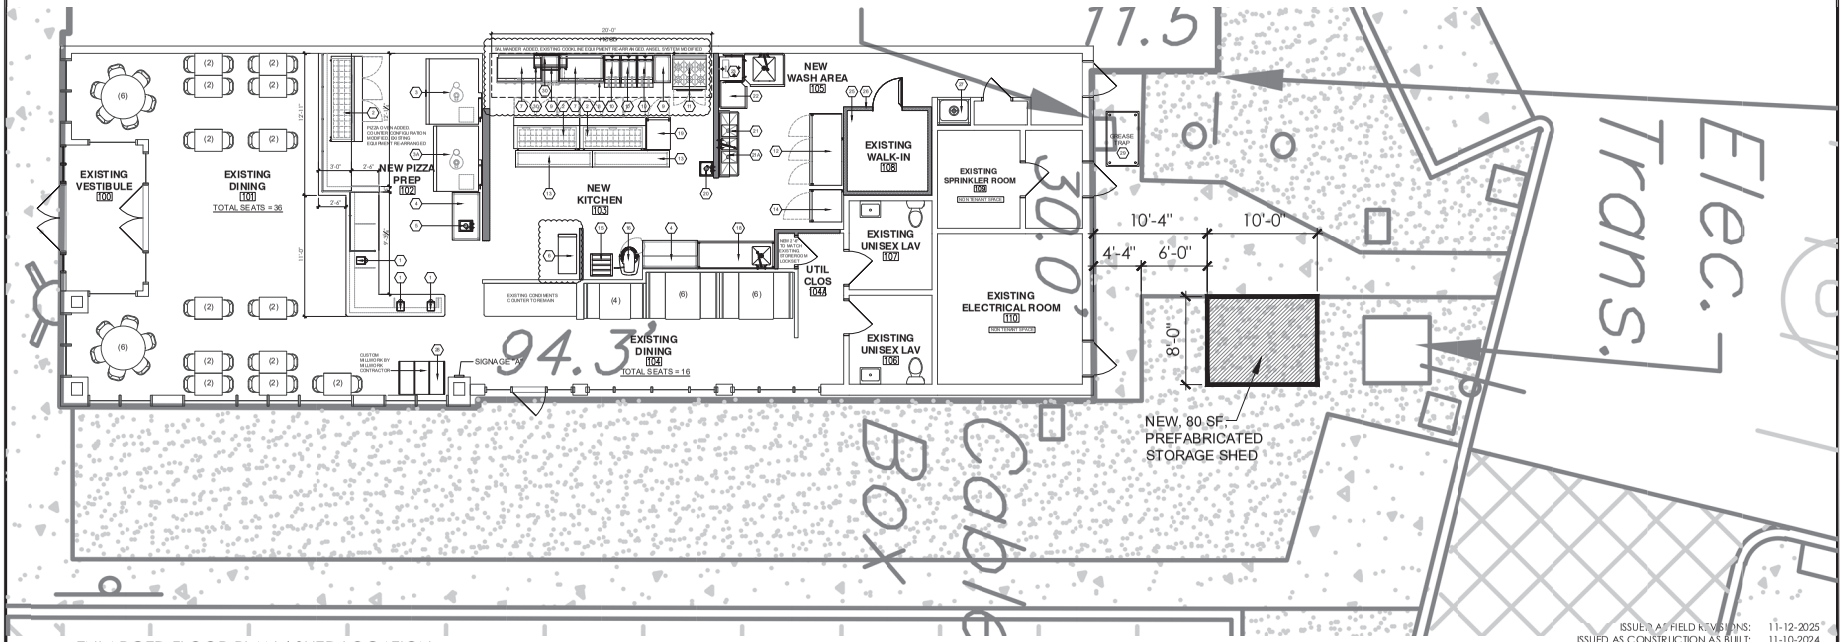

3 ENLARGED FLOOR PLAN / SHED LOCATION
3/16" = 1'-0"

ISSUED AS FIELD REVISIONS: 11-12-2025
ISSUED AS CONSTRUCTION AS BUILT: 11-10-2024
RE-ISSUED TO HEALTH DEPT: 08-22-2024
ISSUED FOR PERMIT: 07-22-2024

M3 Architectural, LLC
701 White Horse Road
Suite 1, 2nd Floor
Voorhees, New Jersey 08043
P: 609-440-9627
E-mail: djm@m3archllc.com

David J. Markowski, AIA, LEED AP, NCARB
Registered Architect

LORENZO'S PIZZA & STEAKS
THE PROMENADE AT SAGEMORE - SPACE B-7
500 ROUTE 73 SOUTH
MARLTON, NJ 08053
PROPOSED EQUIPMENT PLAN

REVISIONS:

DATE:	
PROJECT NO.	
SCALE:	AS NOTED
DRAWN BY:	DJM
SHEET NO.	LORENZO'S

A1.4